


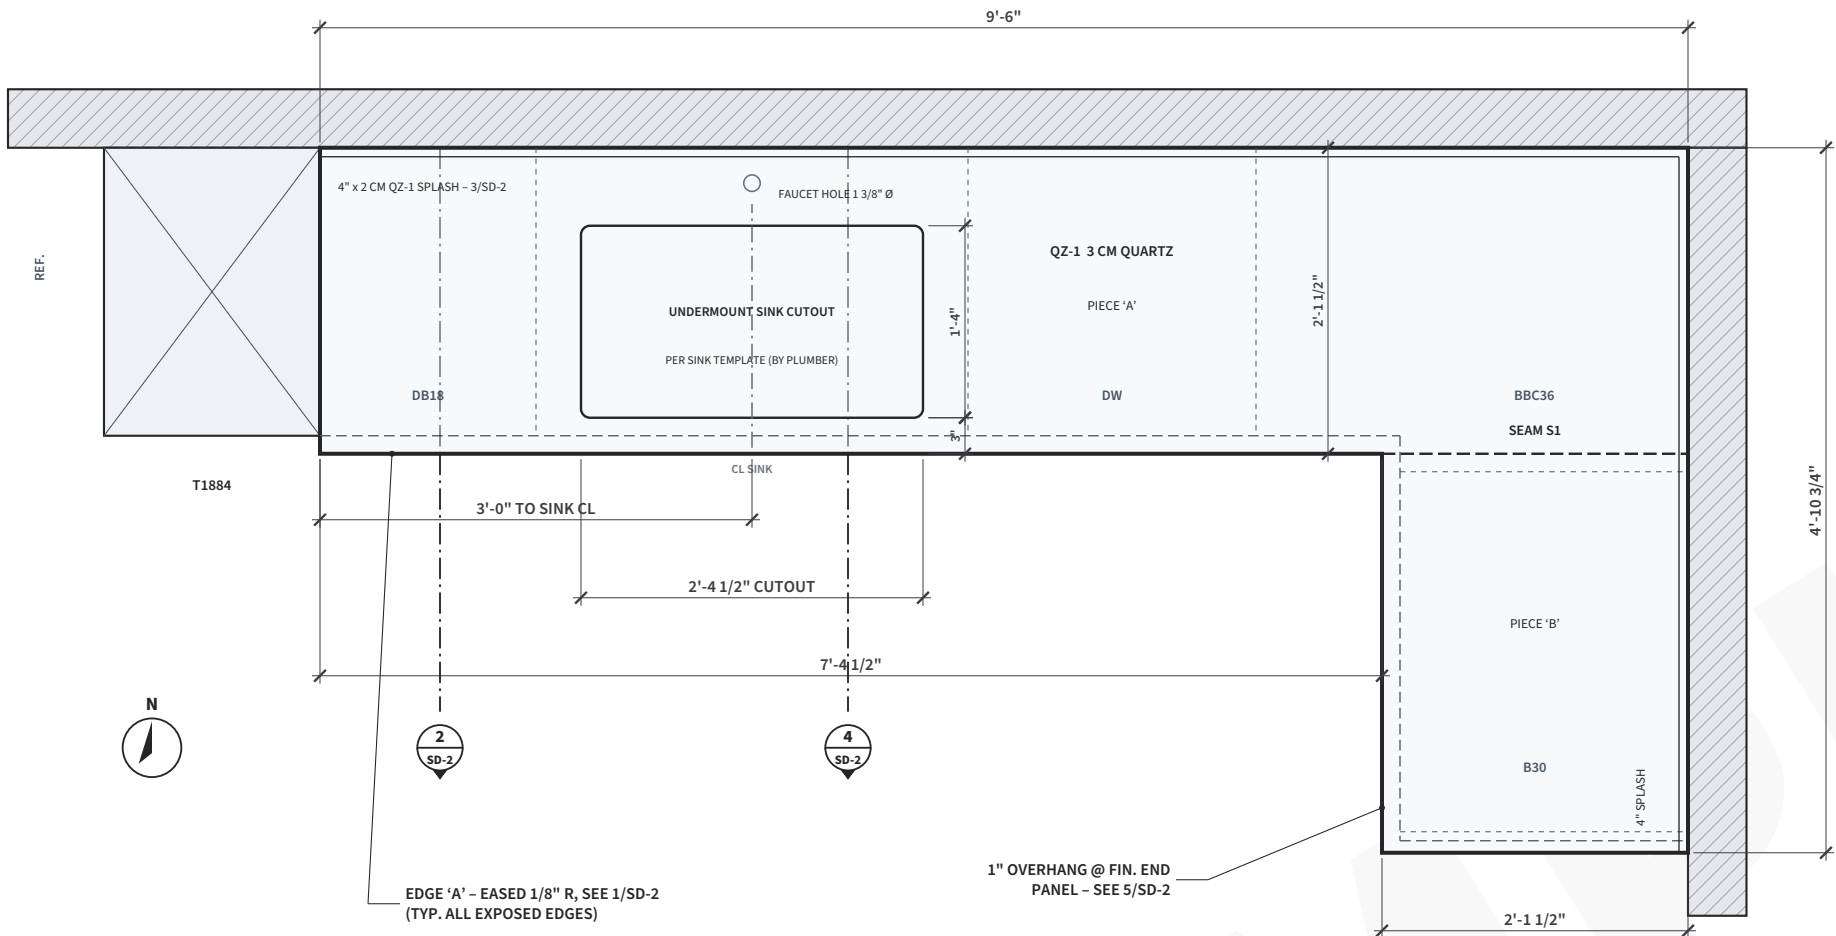


GENERAL NOTES

- All dimensions field verified 10/05/26 after drywall finish. Do not scale drawings.
- Countertop: QZ-1 3 cm, polished; exposed edges eased 1/8" R. Max overhang w/o support 10".
- Seams: 1/16" max, color-matched epoxy, min. 6" from cutouts. Seam S1 at inside corner.
- Undermount sink & faucet by plumbing sub; cutout per manufacturer template (on site 11/06).
- Casework: AWI Custom grade. PL-1 exterior, white TFM interior, 3 mm PVC edge.
- Base cabinets 34 1/2" H on separate 4" toe kick; wall cabinets 12" D, bottom at 54" A.F.F.
- Wall blocking by GC: 2x8 continuous at 32"-36" and 52"-86" A.F.F.
- Rev 2: per architect review - confirm DW opening 24" clear; sink CL 3'-0" from tall cab.

1 COUNTERTOP & CASEWORK PLAN - BREAK ROOM 118

SD-1 SCALE: 3/4" = 1'-0"

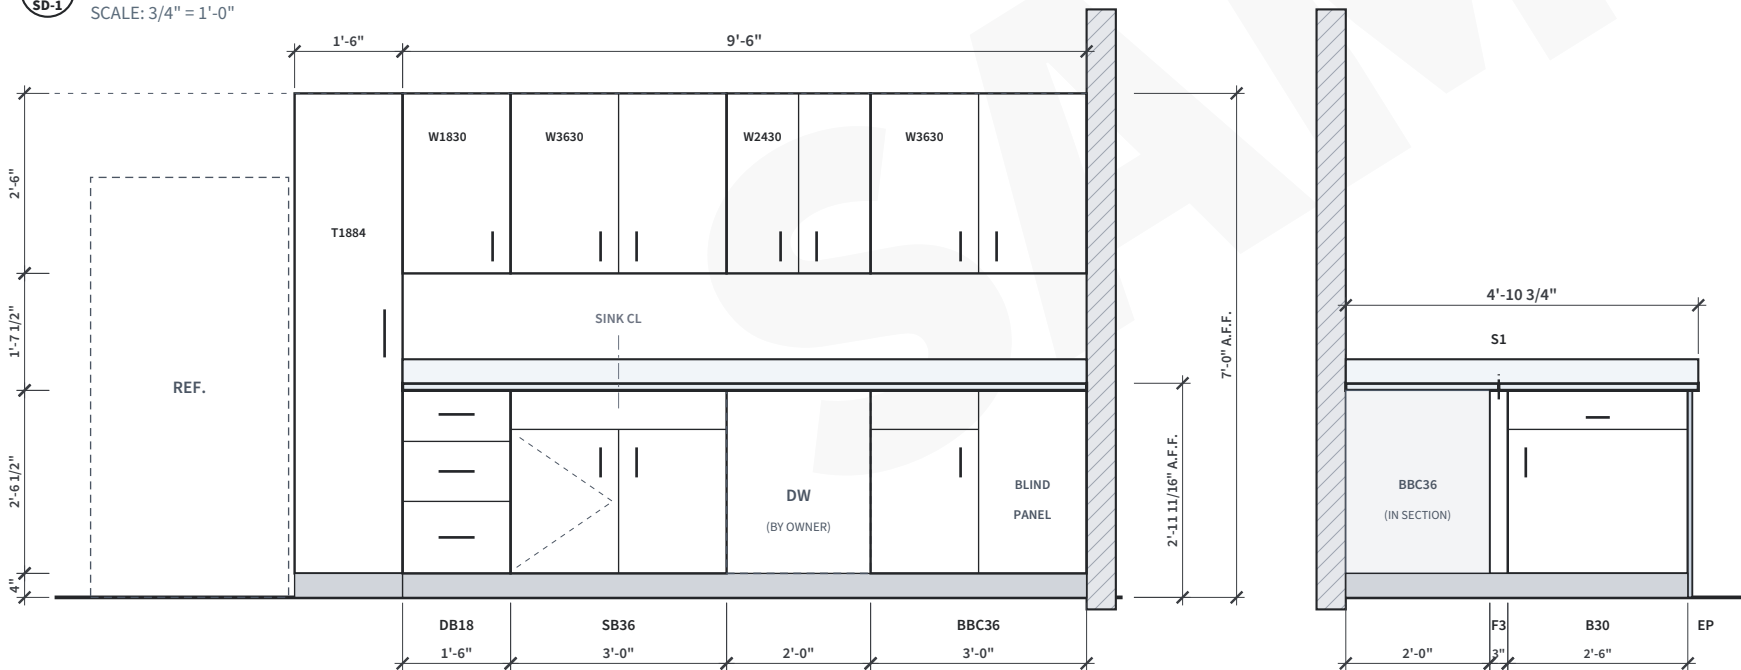

2 ELEVATION A - NORTH WALL

SD-1 SCALE: 3/8" = 1'-0"

3 ELEVATION B - EAST WALL

SD-1 SCALE: 3/8" = 1'-0"

CABINET SCHEDULE - RM 118

TAG	DESCRIPTION	W x H x D	QTY
DB18	Drawer base, 3 drawers	18 x 34 1/2 x 24	1
SB36	Sink base, false front, 2 dr	36 x 34 1/2 x 24	1
BBC36	Blind corner base (blind 18")	36 x 34 1/2 x 24	1
B30	Base, 1 drawer / 2 doors	30 x 34 1/2 x 24	1
F3	Filler, scribe to corner	3 x 34 1/2	1
EP	Finished end panel, PL-1	3/4 x 34 1/2 x 24	1
W1830	Wall, 1 door	18 x 30 x 12	1
W3630	Wall, 2 doors	36 x 30 x 12	2
W2430	Wall, 2 doors	24 x 30 x 12	1
T1884	Tall pantry, 4 adj. shelves	18 x 84 x 24	1

COUNTERTOP SUMMARY

PIECE	SIZE	SF
A - run A incl. corner	9'-6" x 2'-1 1/2"	20.19
B - run B return	2'-9 1/4" x 2'-1 1/2"	5.89
Splash (2 CM, 4")	14'-4 3/4" total LF	4.80
TOTAL QZ-1 (est. 31 SF)	1 cutout · 1 faucet hole	30.87



Drafting & Shop Drawing Services
[Phone] · [Email] · axentra-solutions.com

PROJECT

Riverside Medical Office Build-Out

1450 Riverbend Parkway, Suite 200
Anytown, ST 00000
Job no. 26-118

FABRICATOR / INSTALLER (CLIENT)

Summit Surfaces & Interiors, LLC

Casework & countertop subcontractor

GENERAL CONTRACTOR · ARCHITECT

Northgate Builders, Inc.

Lumen Architecture Studio

MATERIALS

QZ-1 3 cm quartz - "Glacier Mist", polished
PL-1 HPL - "Gray Linen" (PL-1), matte
Interior: white TFM · 3 mm PVC edgeband
Hardware: 110° concealed hinges, FEXT slides

REVISIONS

REV	DATE	DESCRIPTION	BY
0	09/14/26	Issued for approval	PPO
1	09/28/26	Sink CL moved per RFI-004; DW opening	PPO
2	10/06/26	Incorporate review notes; F.V. dims	PPO

ARCHITECT / GC REVIEW STAMP

- ☐ Approved ☒ Approved as noted
☐ Revise & resubmit ☐ Rejected

P. Nair, Lumen Architecture Studio - 10/02/26
Note: verify sink CL at rough-in (see Rev 1).

SAMPLE - Fictional project for demonstration. All names, companies and dimensions are fictional. Not for construction.


DRAWING TITLE

BREAK ROOM 118 CASEWORK & QUARTZ COUNTERTOP PLAN, ELEVATIONS & SCHEDULE


DRAWN Axentra Drafting	CHECKED D. Whitfield
DATE 09/14/26	SCALE AS NOTED
SHOP DWG NO. SD-26118-118	FIELD VERIFIED 10/05/26
SHEET	REVISION

SD-1


2

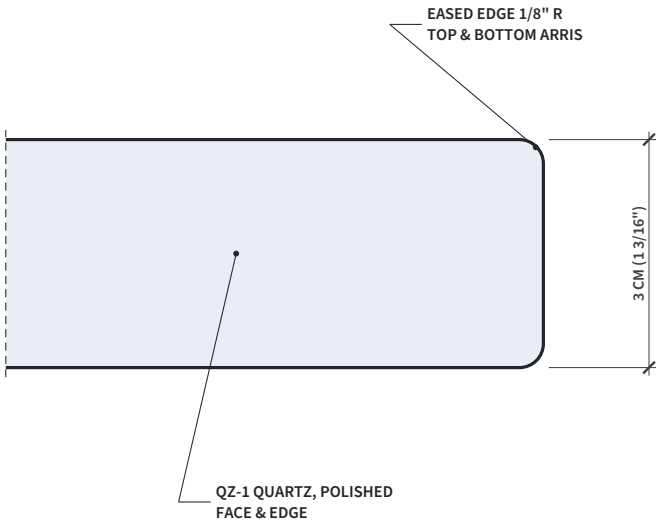


1 **EDGE PROFILE 'A' - EASED**
SD-2 SCALE: FULL SIZE (1:1)

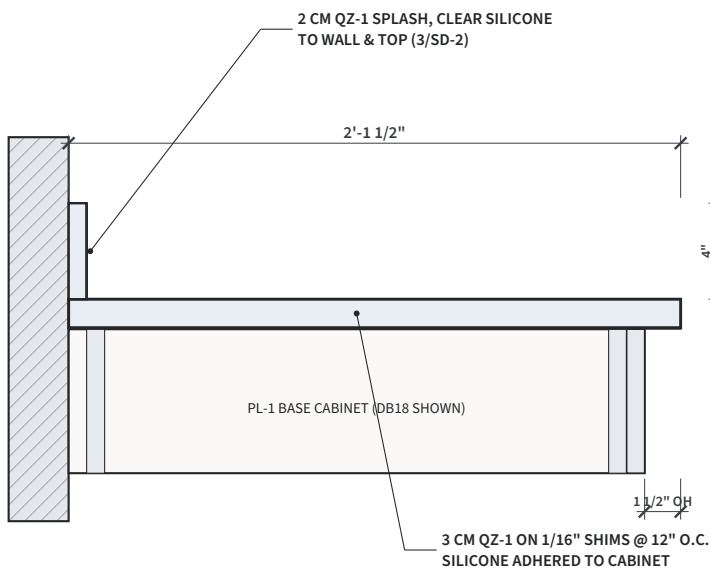


2 **TYPICAL COUNTERTOP SECTION**
SD-2 SCALE: 1 1/2" = 1'-0"

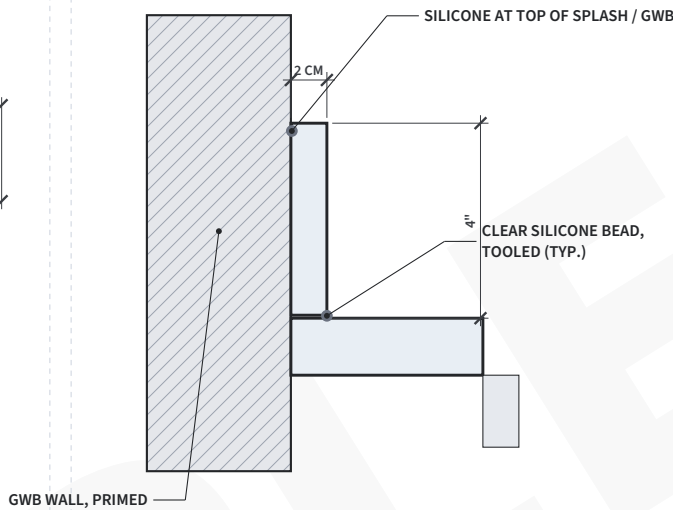


3 **BACKSPLASH DETAIL**
SD-2 SCALE: 3" = 1'-0"

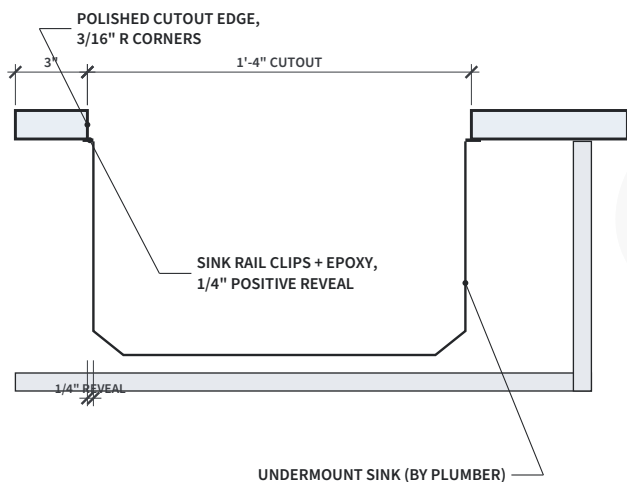

4 **UNDERMOUNT SINK SECTION**
SD-2 SCALE: 1 1/2" = 1'-0"

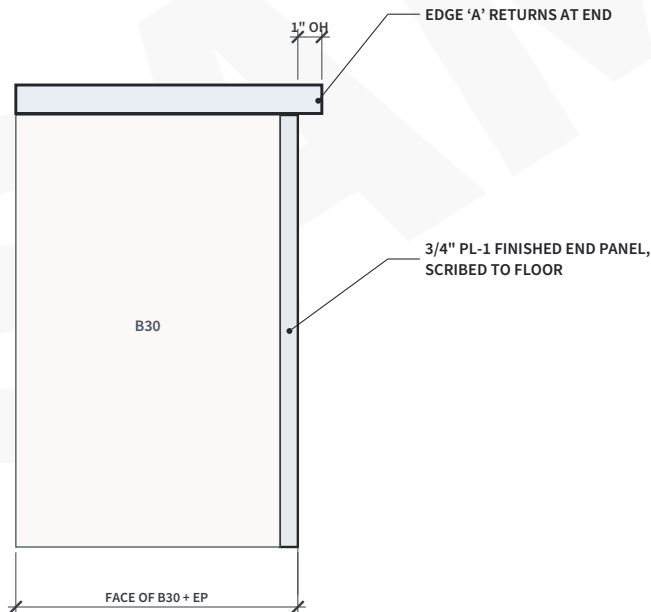

5 **OVERHANG AT FINISHED END**
SD-2 SCALE: 1 1/2" = 1'-0"

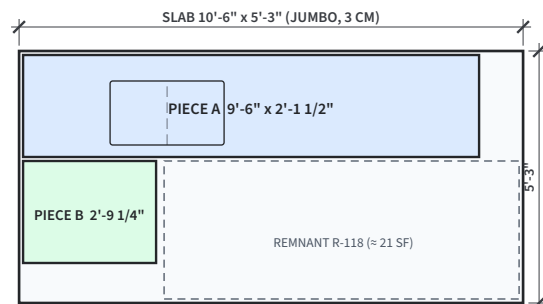

Slab 1 of 3 (Lot QZ-26-4471). Pieces A + B = 26.1 SF of 55.1 SF slab. Splashes cut from 2 CM slab S-4 (shared w/ Rm 105). Remnant R-118 tagged for Nurse Station 105 transaction ledge. Slabs 2-3: Reception 102 & Nurse Station 105 (SD-26118-102/105).

6 **SLAB LAYOUT / NESTING - SLAB 1**
SD-2 SCALE: 1/4" = 1'-0"



Drafting & Shop Drawing Services
[Phone] · [Email] · axentra-solutions.com

PROJECT
Riverside Medical Office Build-Out
1450 Riverbend Parkway, Suite 200
Anytown, ST 00000
Job no. 26-118

FABRICATOR / INSTALLER (CLIENT)
Summit Surfaces & Interiors, LLC
Casework & countertop subcontractor

GENERAL CONTRACTOR · ARCHITECT
Northgate Builders, Inc.
Lumen Architecture Studio

MATERIALS
QZ-1 3 cm quartz – “Glacier Mist”, polished
PL-1 HPL – “Gray Linen” (PL-1), matte
Interior: white TFM · 3 mm PVC edgeband
Hardware: 110° concealed hinges, FEXT slides

REV	DATE	DESCRIPTION	BY
0	09/14/26	Issued for approval	PPO
1	09/28/26	Sink CL moved per RFI-004; DW opening	PPO
2	10/06/26	Incorporate review notes; F.V. dims	PPO

ARCHITECT / GC REVIEW STAMP

☐ Approved ☒ Approved as noted
☐ Revise & resubmit ☐ Rejected

P. Nair, Lumen Architecture Studio – 10/02/26
Note: verify sink CL at rough-in (see Rev 1).

SAMPLE - Fictional project for demonstration. All names, companies and dimensions are fictional. Not for construction.

DRAWING TITLE
BREAK ROOM 118
COUNTERTOP & CASEWORK
DETAILS & SLAB LAYOUT

DRAWN Axentra Drafting	CHECKED D. Whitfield
DATE 09/14/26	SCALE AS NOTED
SHOP DWG NO. SD-26118-118	FIELD VERIFIED 10/05/26

SHEET **REVISION**